



FAN SHUTDOWN DAMPER CLOSING PANEL – DETAIL 1

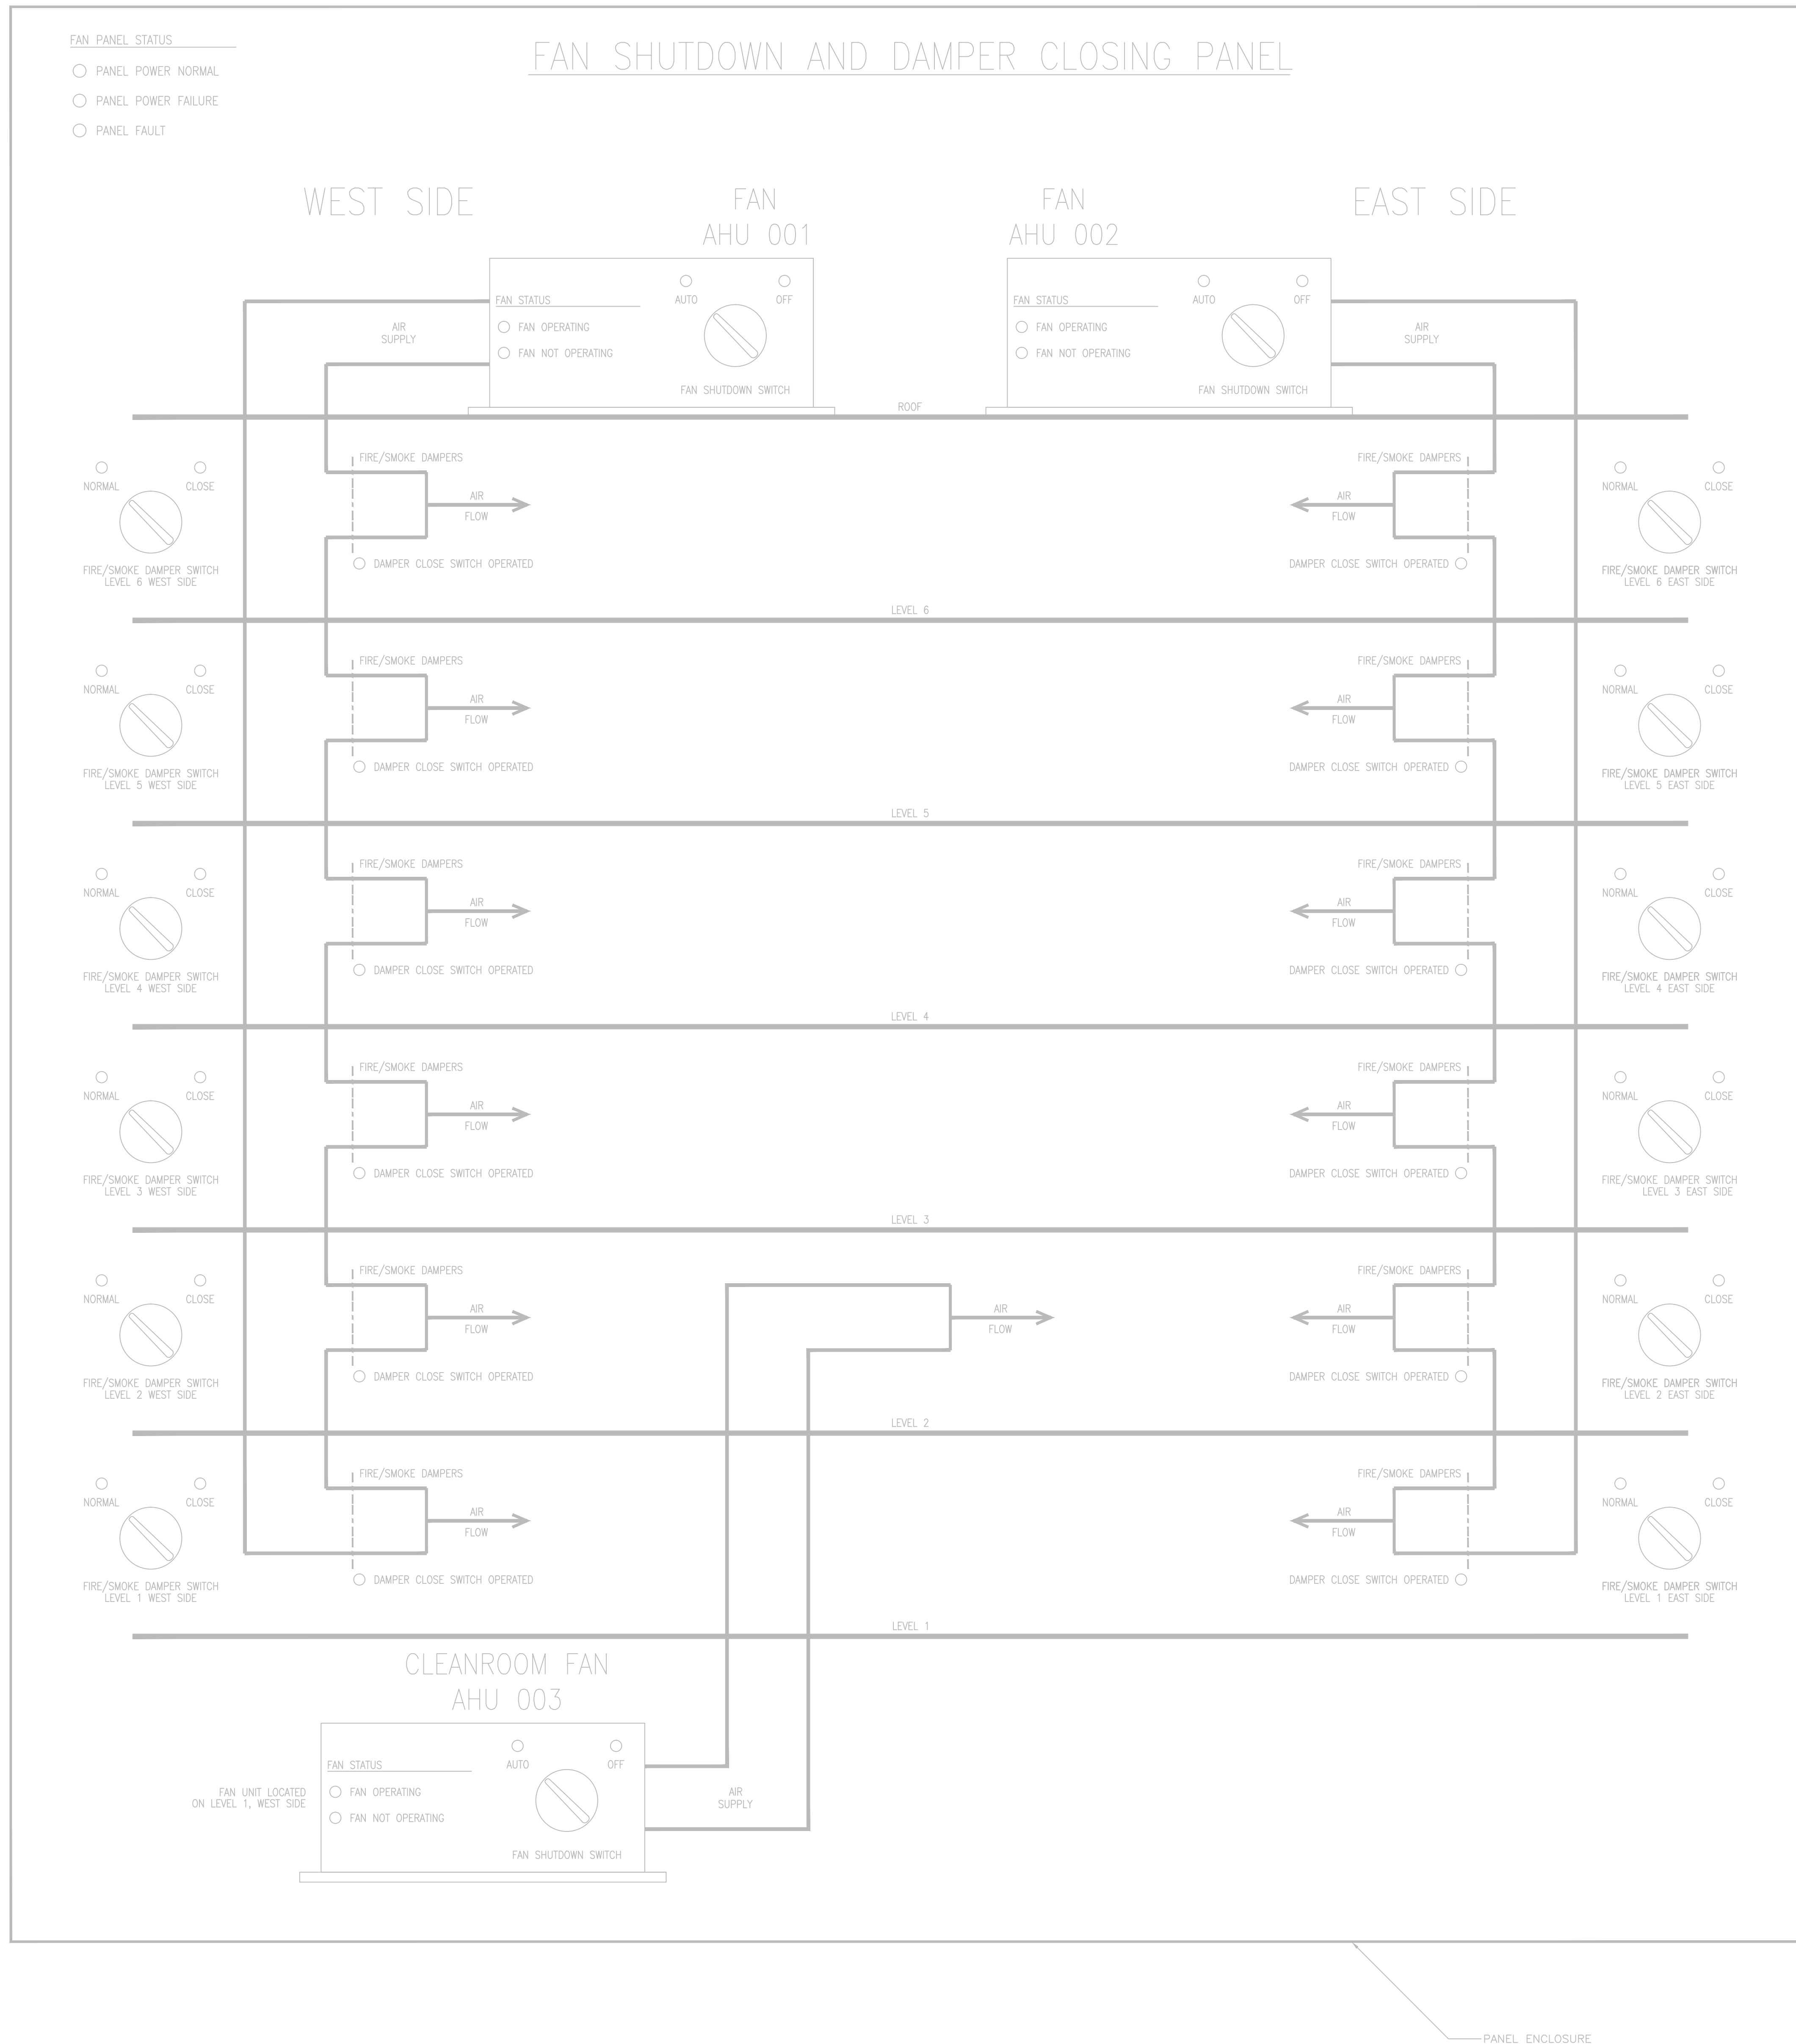


FAN SHUTDOWN DAMPER CLOSING PANEL DETAILS – DETAIL 2

FAN SHUTDOWN DAMPER CLOSING RISER DIAGRAM – DETAIL 3

FAN/DAMPER & MXL/MXLR PANEL INTERACTIONS – DETAIL 4

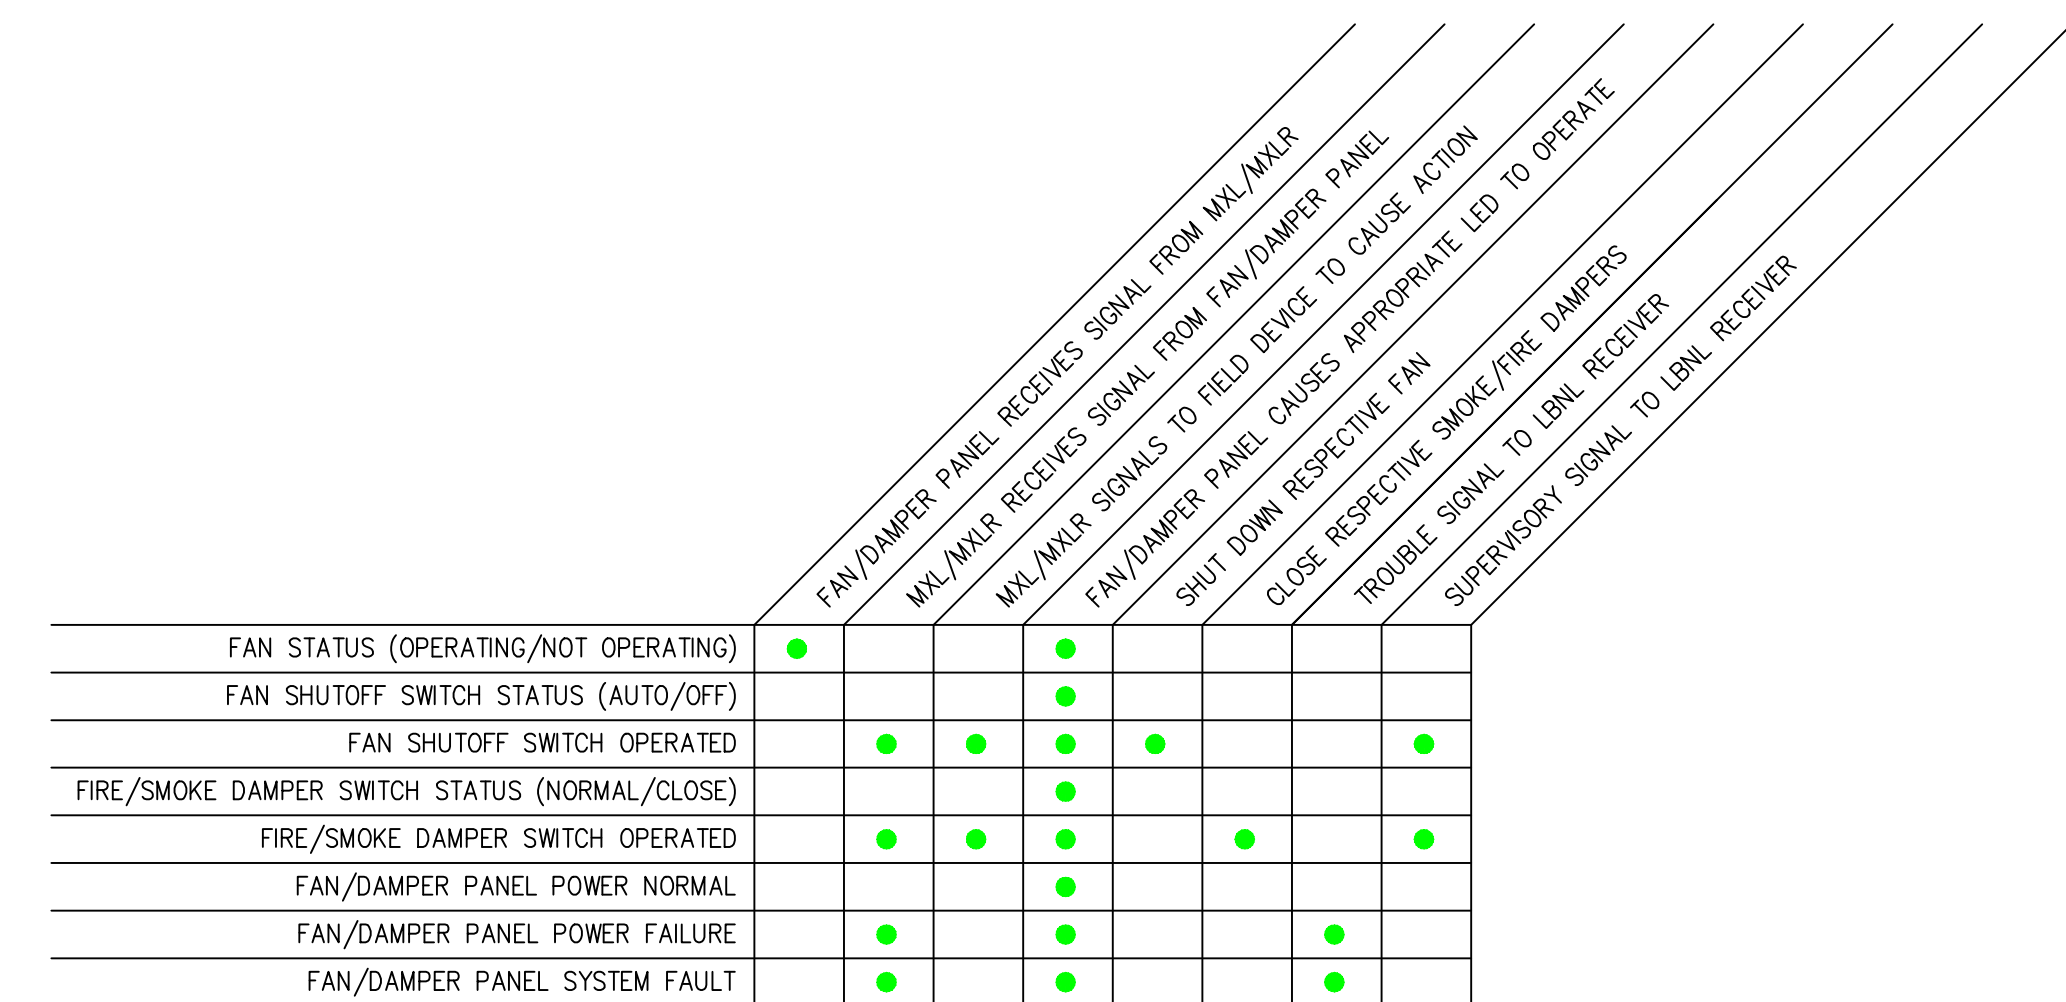

FIRE ALARM SYSTEM LEGEND

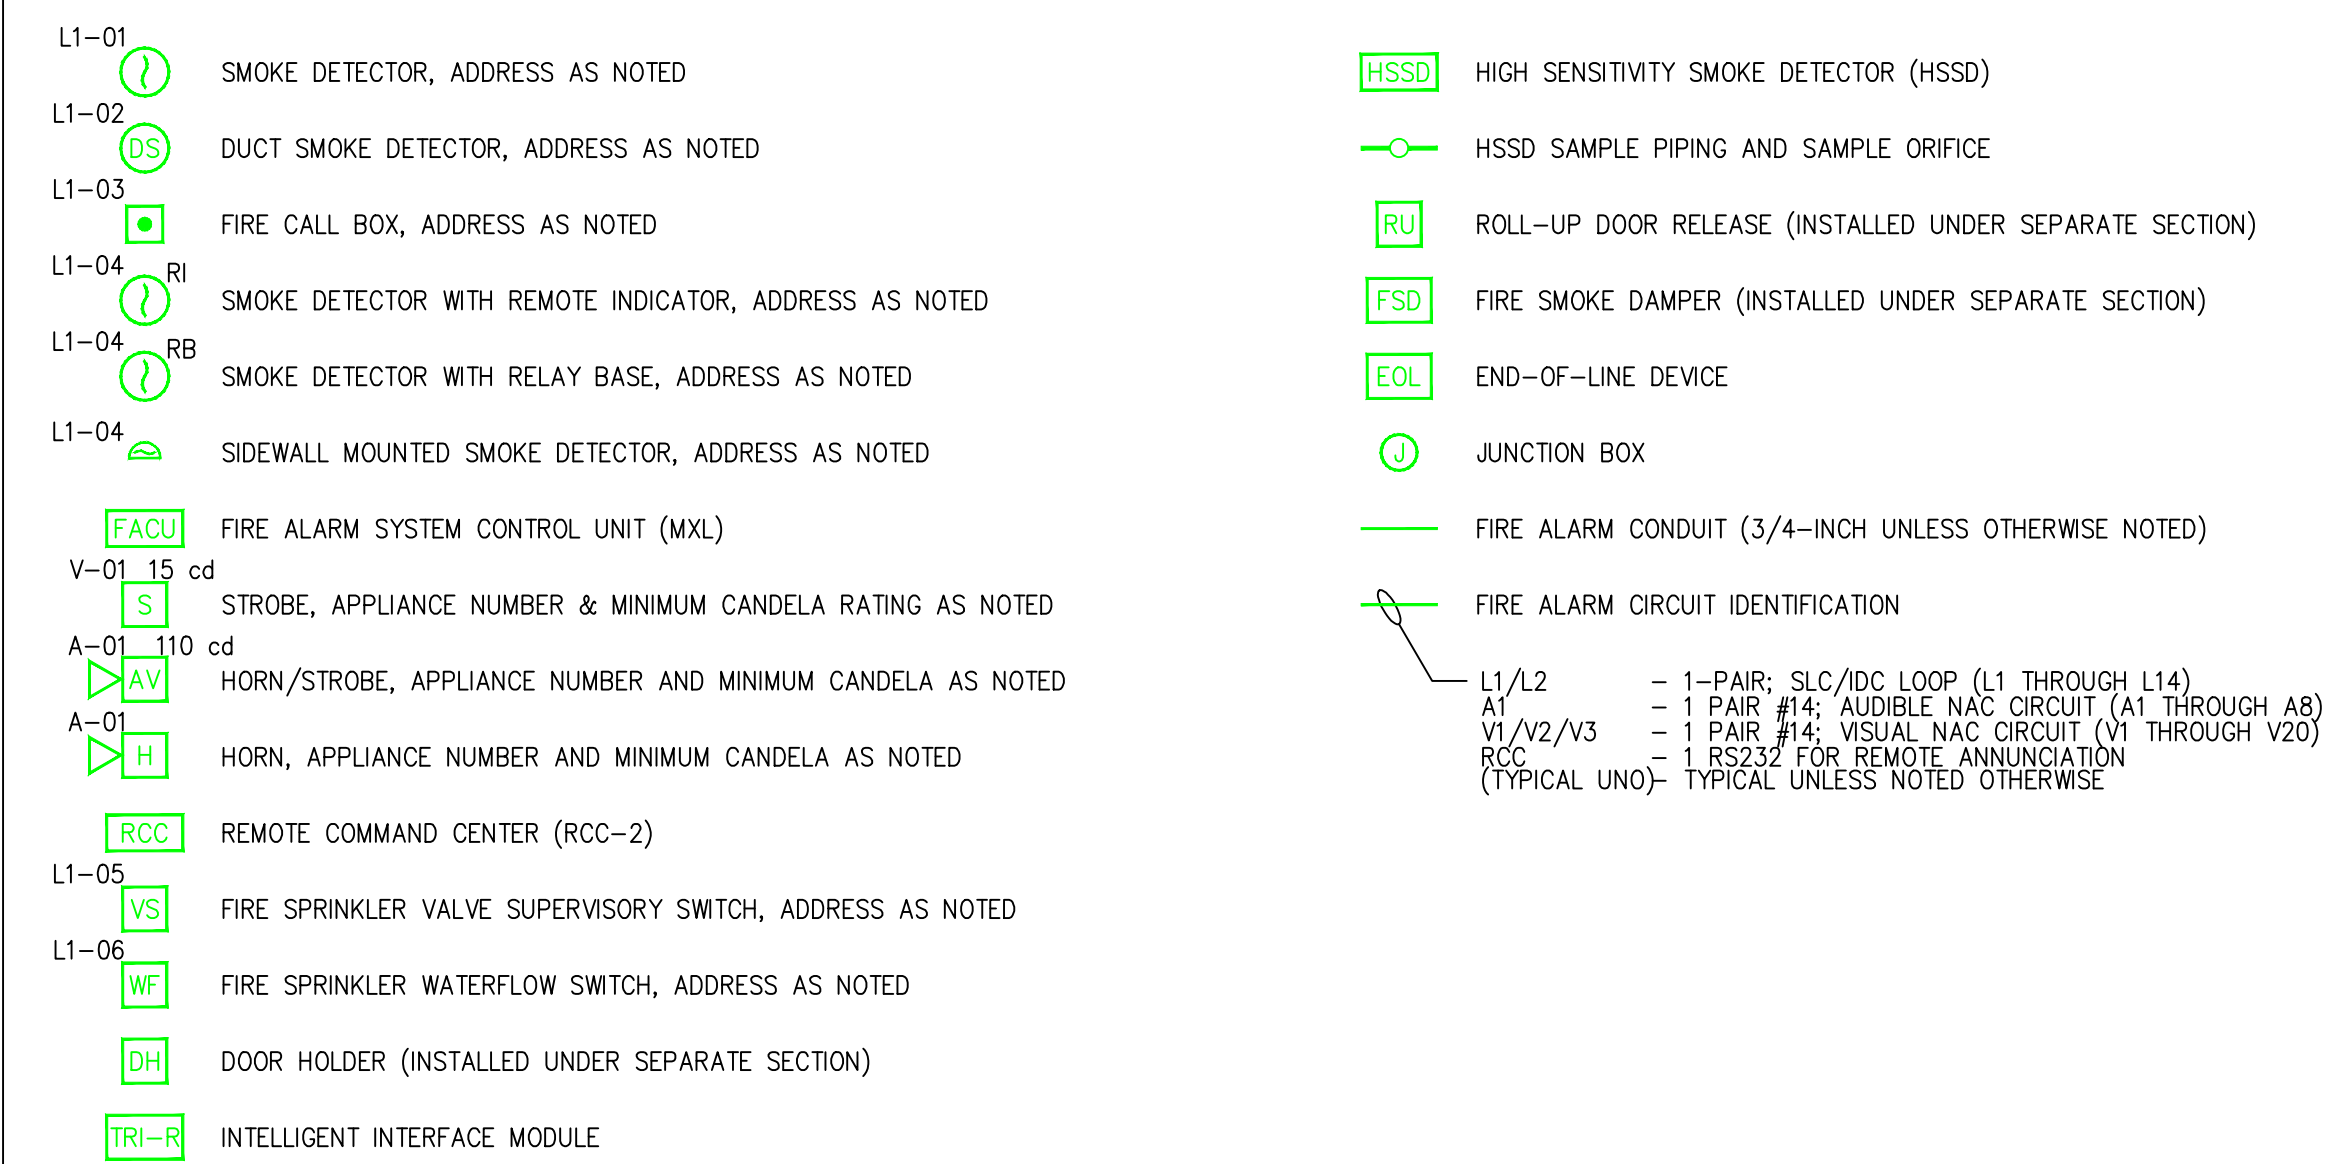[illegible]


Seals and Signatures

RECORD DRAWINGS-

SPECIAL NOTE:
THE INFORMATION SHOWN IN THIS
DRAWING WAS DEVELOPED USING THE
RECORD DRAWINGS PROVIDED BY SIEMENS
BUILDING TECHNOLOGIES, INC. FOLLOWING
THE COMPLETION OF THIS PROJECT
(IDENTIFIED AS JOB NUMBER 107739,
SHEETS 1 THROUGH 24). SPECIFICALLY,
SEE SHEET 13 OF 24 FOR INFORMATION.

[illegible]

Key Plan

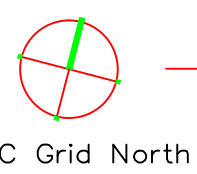

Drawing Title

Scale

SG Project Number	LBNL Project Number
1	1
2	2
3	3
100	100

Drawing Number 6 OF 20

LBNL Drawing Number IFB 841

Plot Sheet Filename: JOBS\JOBNUMBER\FILENAME
XREF Filename List: JOBS\JOBNUMBER\FILENAME
Named Page Setup: PAGE SETUP
Plot Layout: PSPACE: SHEET @ 1:1
Plot Date:

LBNL Drawing Status:
LBNL Issue Status:
LBNL Revision:
LBNL Date: